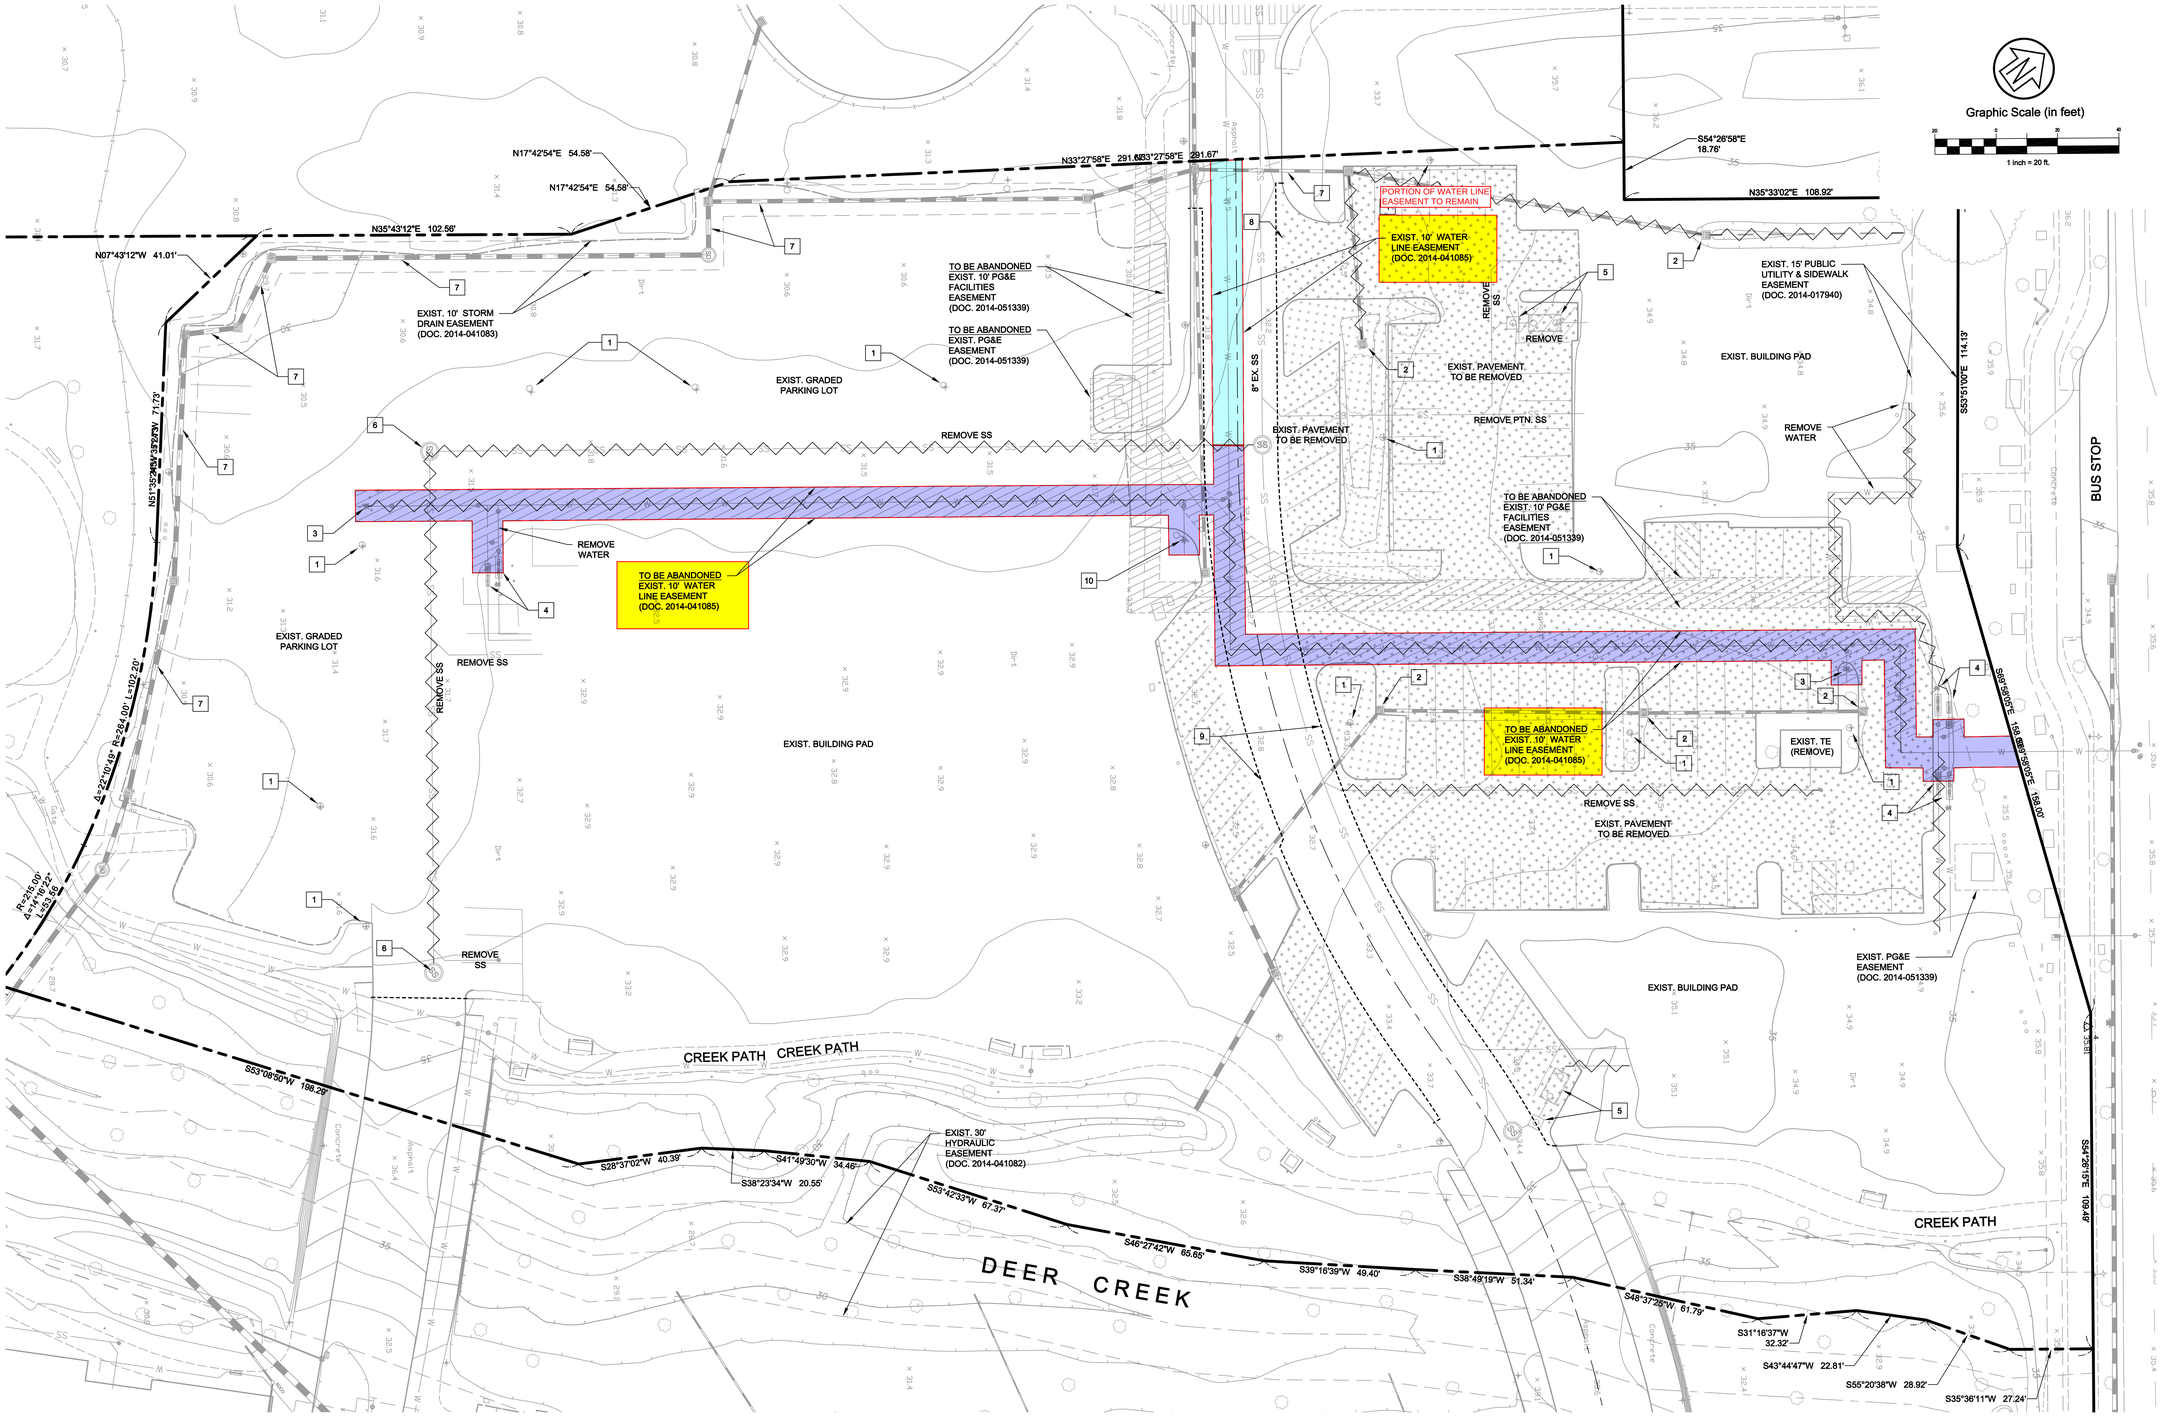

LEGEND

- EXISTING PAVEMENT TO BE REMOVED
- LANDSCAPE AREA

DEMOLITION KEYNOTES

1	REMOVE PARKING LOT LIGHT STANDARD (PRESERVE)
2	REMOVE DRAIN STRUCTURE
3	REMOVE FIRE HYDRANT (PRESERVE)
4	REMOVE WATER SERVICE AND FIRE SERVICE (PRESERVE BACKFLOW DEVICES)
5	REMOVE GREASE INTERCEPTOR AND SAMPLING MANHOLE
6	REMOVE SEWER MANHOLE
7	EXISTING STORM DRAIN TO REMAIN. CONTRACTOR TO VIDEO PRIOR TO CONSTRUCTION.
8	CONCRETE/ASPHALT PAVEMENT CONFORM
9	SAWCUT/CONFORM
10	FIRE HYDRANT TO REMAIN (PRESERVE)

NOTE:
1. EXISTING UTILITIES TO BE REMOVED SHALL INCLUDE EXCAVATION, REMOVAL OF TRENCH MATERIAL, PIPES, CONDUITS AND STRUCTURES. TRENCHES AND EXCAVATIONS SHALL BE BACKFILLED IN ACCORDANCE WITH THE RECOMMENDATIONS IN THE GEOTECHNICAL REPORT OR ACCORDING TO THE GEOTECHNICAL ENGINEER.
2. PLUG OPENINGS ON STRUCTURES TO REMAIN.

EXPECTED WATER LINE EASEMENTS TO BE ABANDONED
NOTE: TO BE CONFIRMED WITH CITY OF PETALUMA PUBLIC WORKS/WATER RESOURCES

CSWST2 JOB NO.	21.10.121
ISSUED FOR CONSTRUCTION	01-18-2023

REVISION	DATE
1	01/30/2023 GEOTECH REVIEW RESPONSE

MBK RENTAL LIVING
AN MBK REAL ESTATE COMPANY

THE HAVEN AT DEER CREEK
429 NORTH McDOWELL BLVD.
PETALUMA, CA

MBK RENTAL LIVING
4 PARK PLAZA, SUITE 1700
IRVINE, CA. 92614

CSW | ST2
CSW/Stuber-Stroeh Engineering Group, Inc.
45 Leveroni Court Novato, CA 94949
tel: 415.883.9850 www.cswst2.com
Civil Engineering Planning Surveying & Mapping
© 2022

SHEET TITLE
EXISTING CONDITION/ DEMOLITION PLAN

SHEET NO.
C9.0

01-18-2023
ISSUED FOR CONSTRUCTION